


J:\Lester Properties\2080131 Mill Race Commons - As Built Survey\CADD\00_Preliminary\Arch\BOMA_080417.dwg

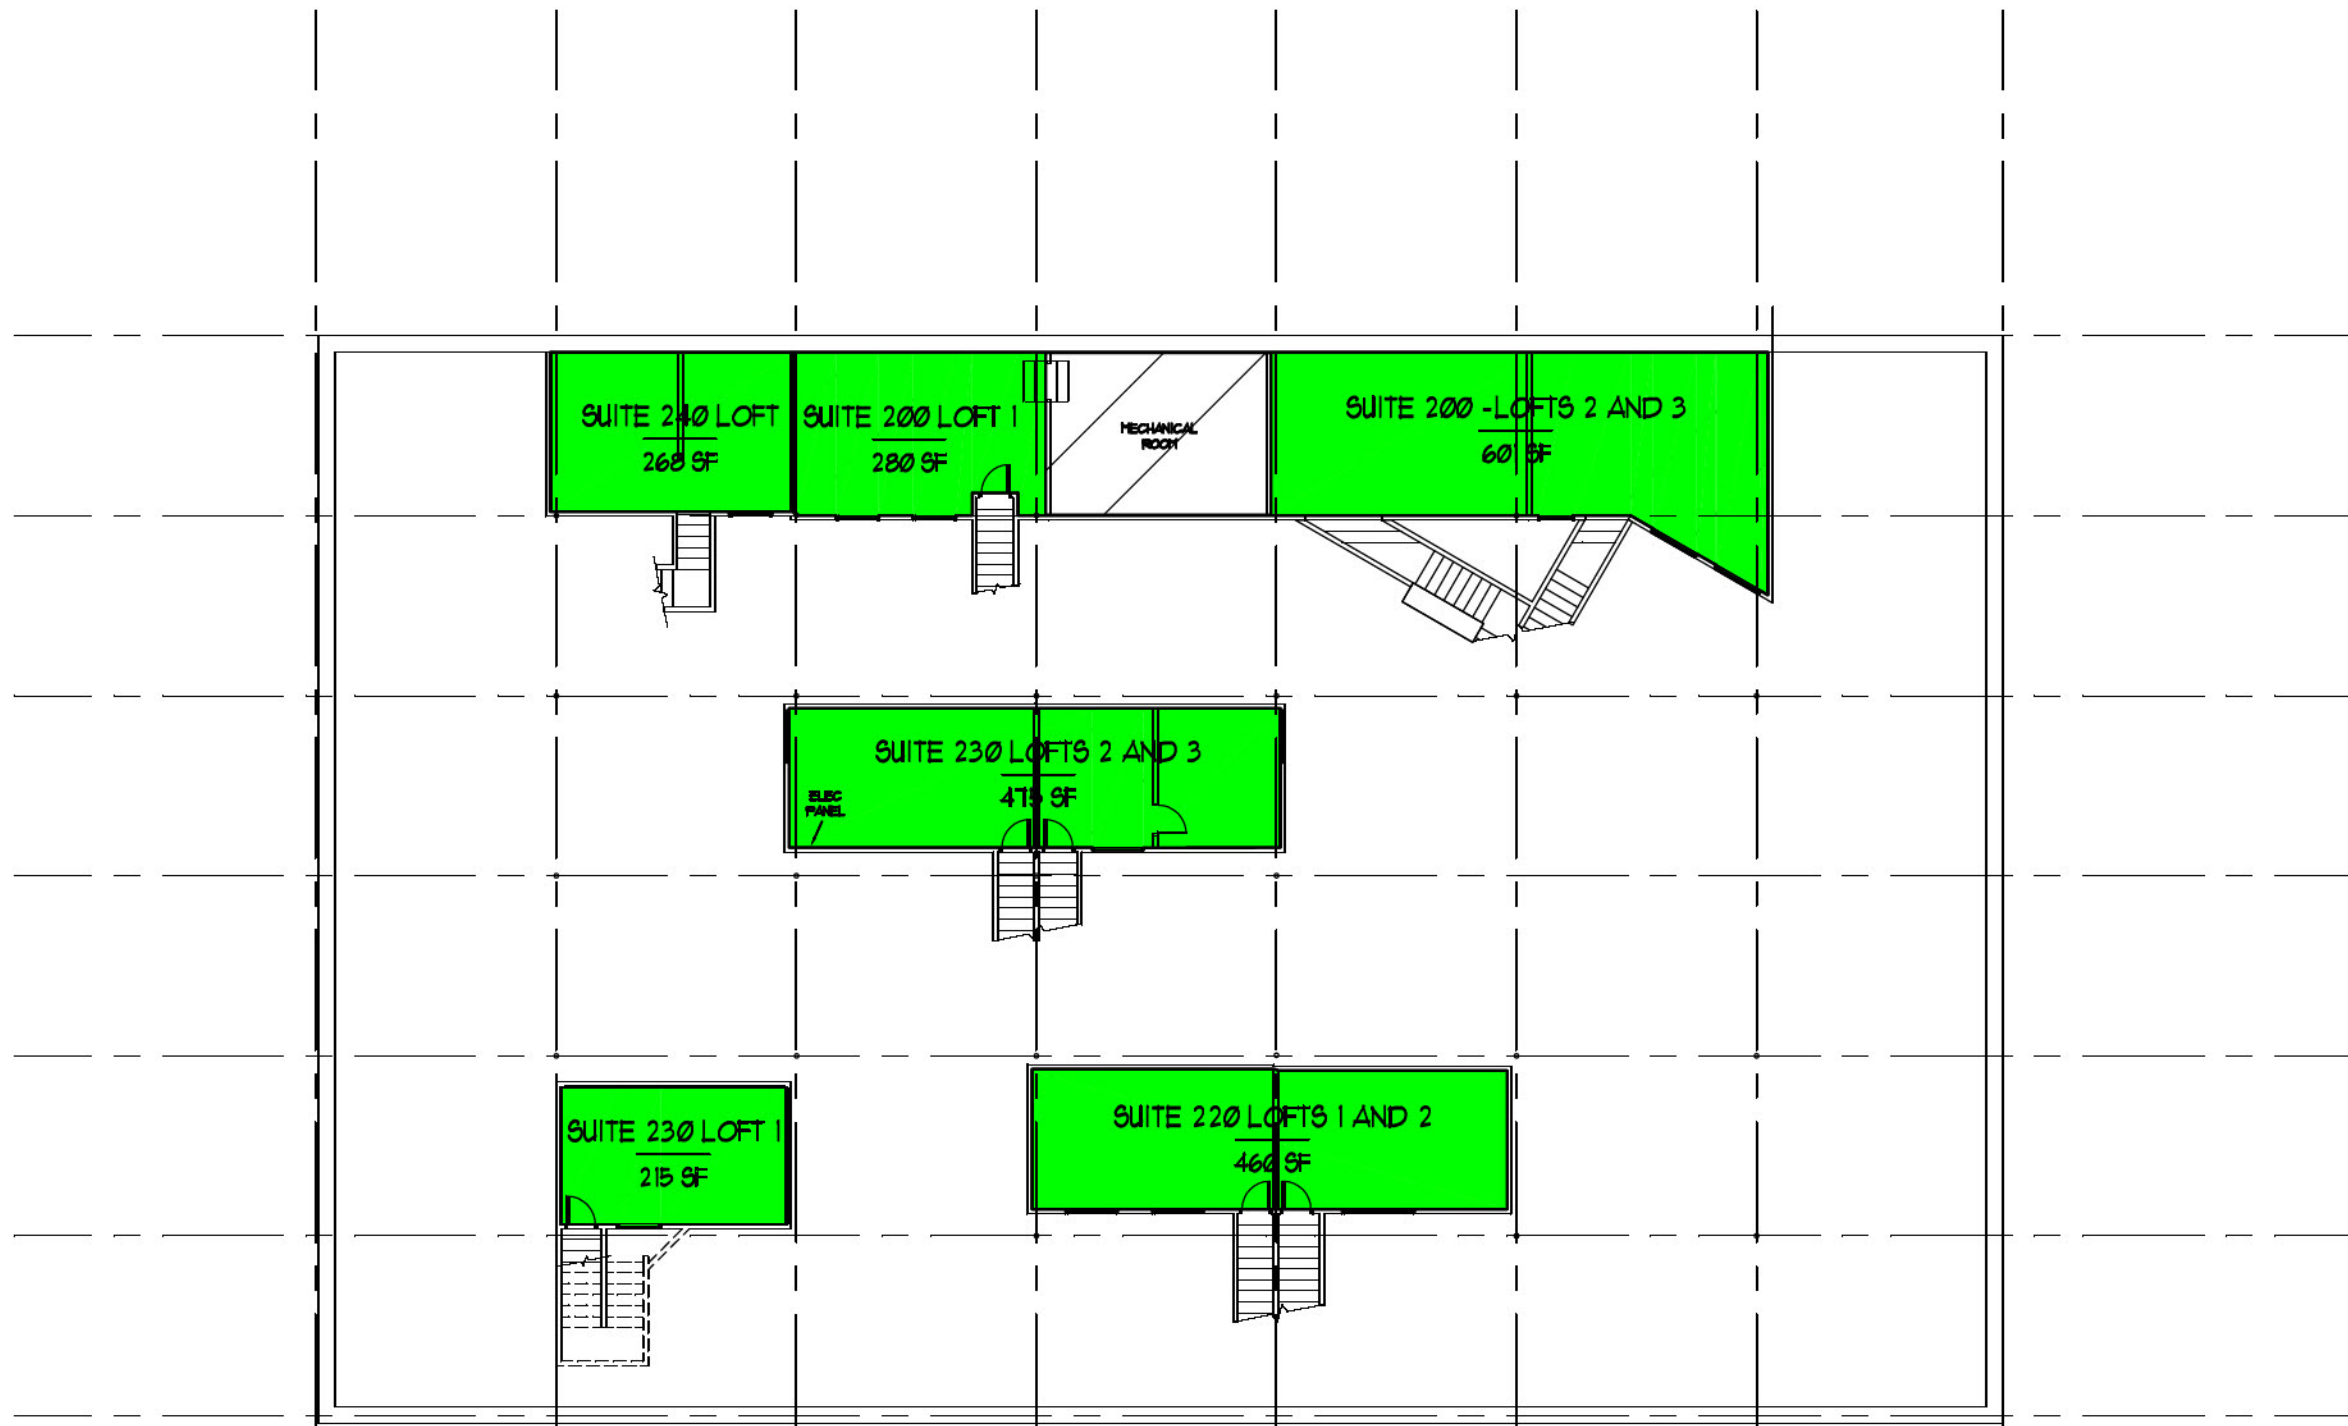

Baskervill

ask + listen + create

Ship to or visit
101 S 15th St
Ste 200 • 23219

P.O. Box 400
Richmond, Va
23218 • 0400

804 343 1010
fax 343 0909
baskervill.com

Lester Properties
Mill Race Commons BOMA - SECOND FLOOR LOFTS

an intelligent
engineering
interior design