



FREIGHT
ELEVATOR

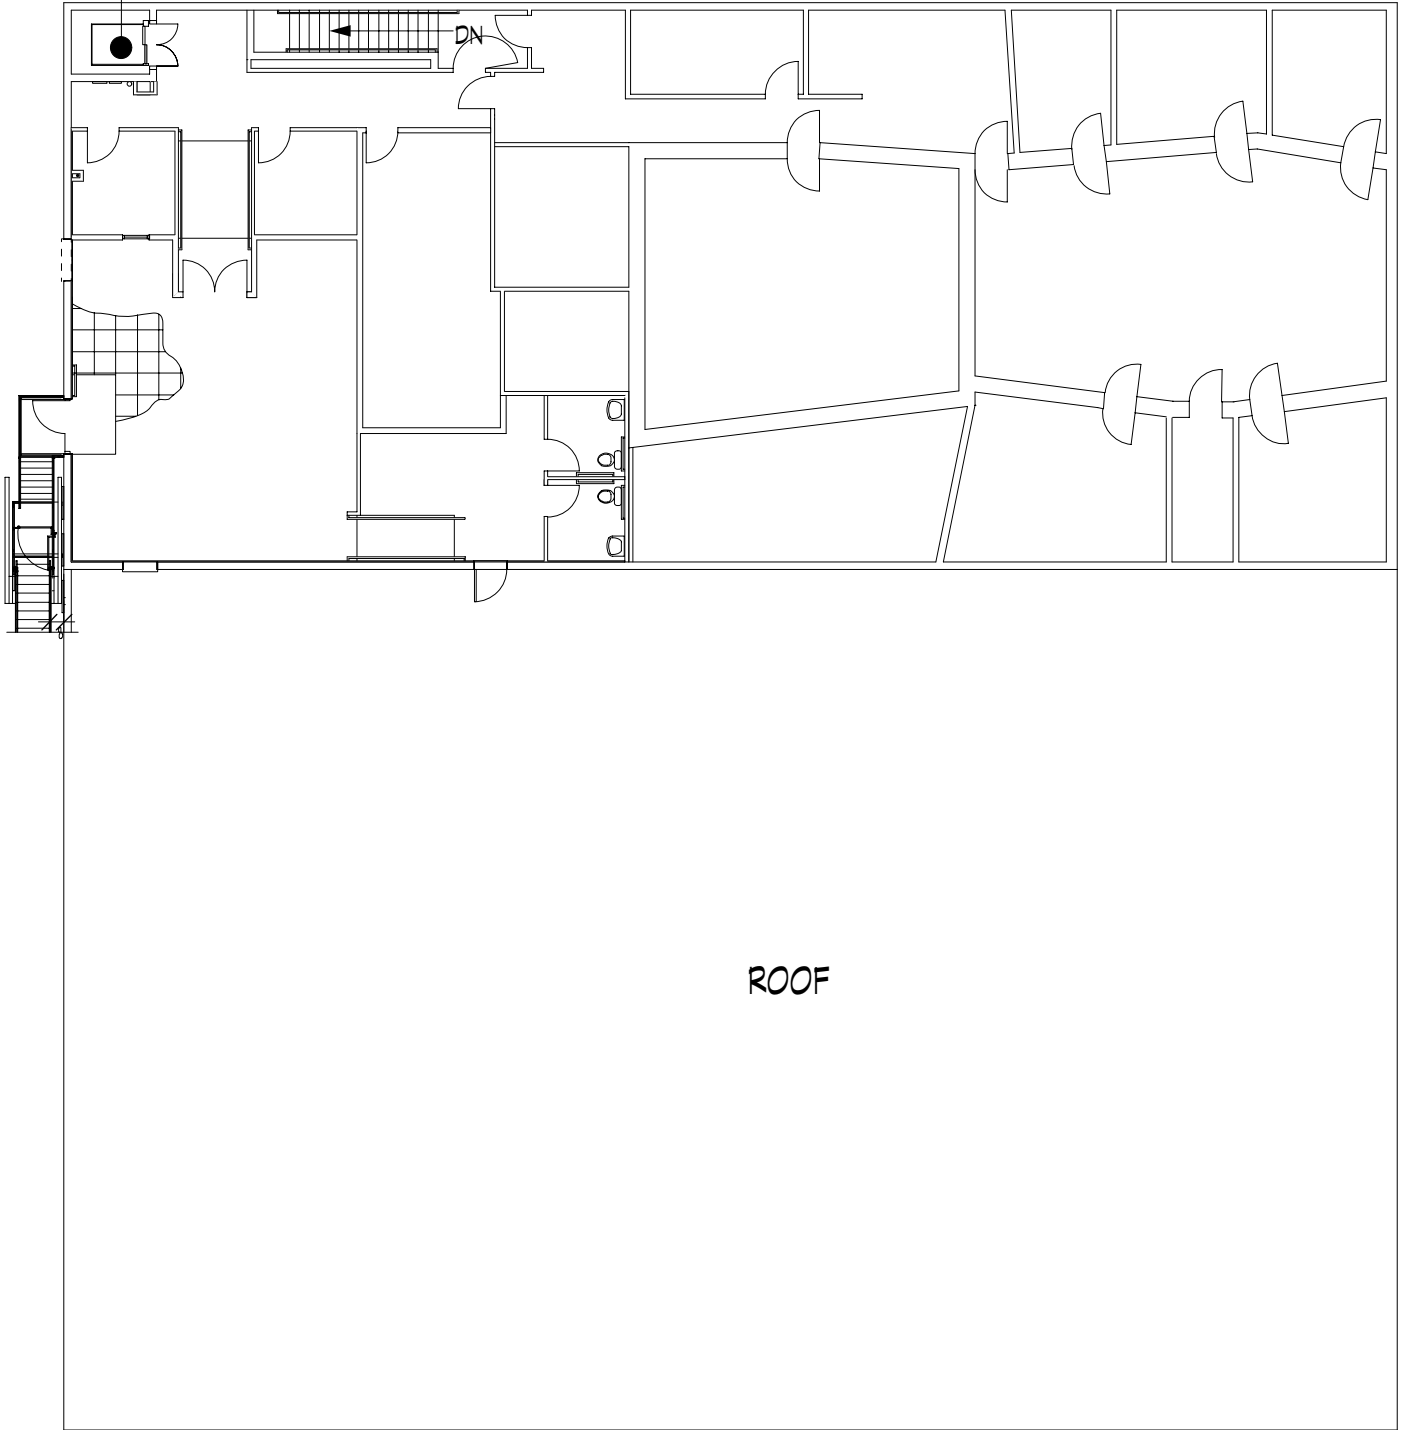

UPPER FLOOR PLAN

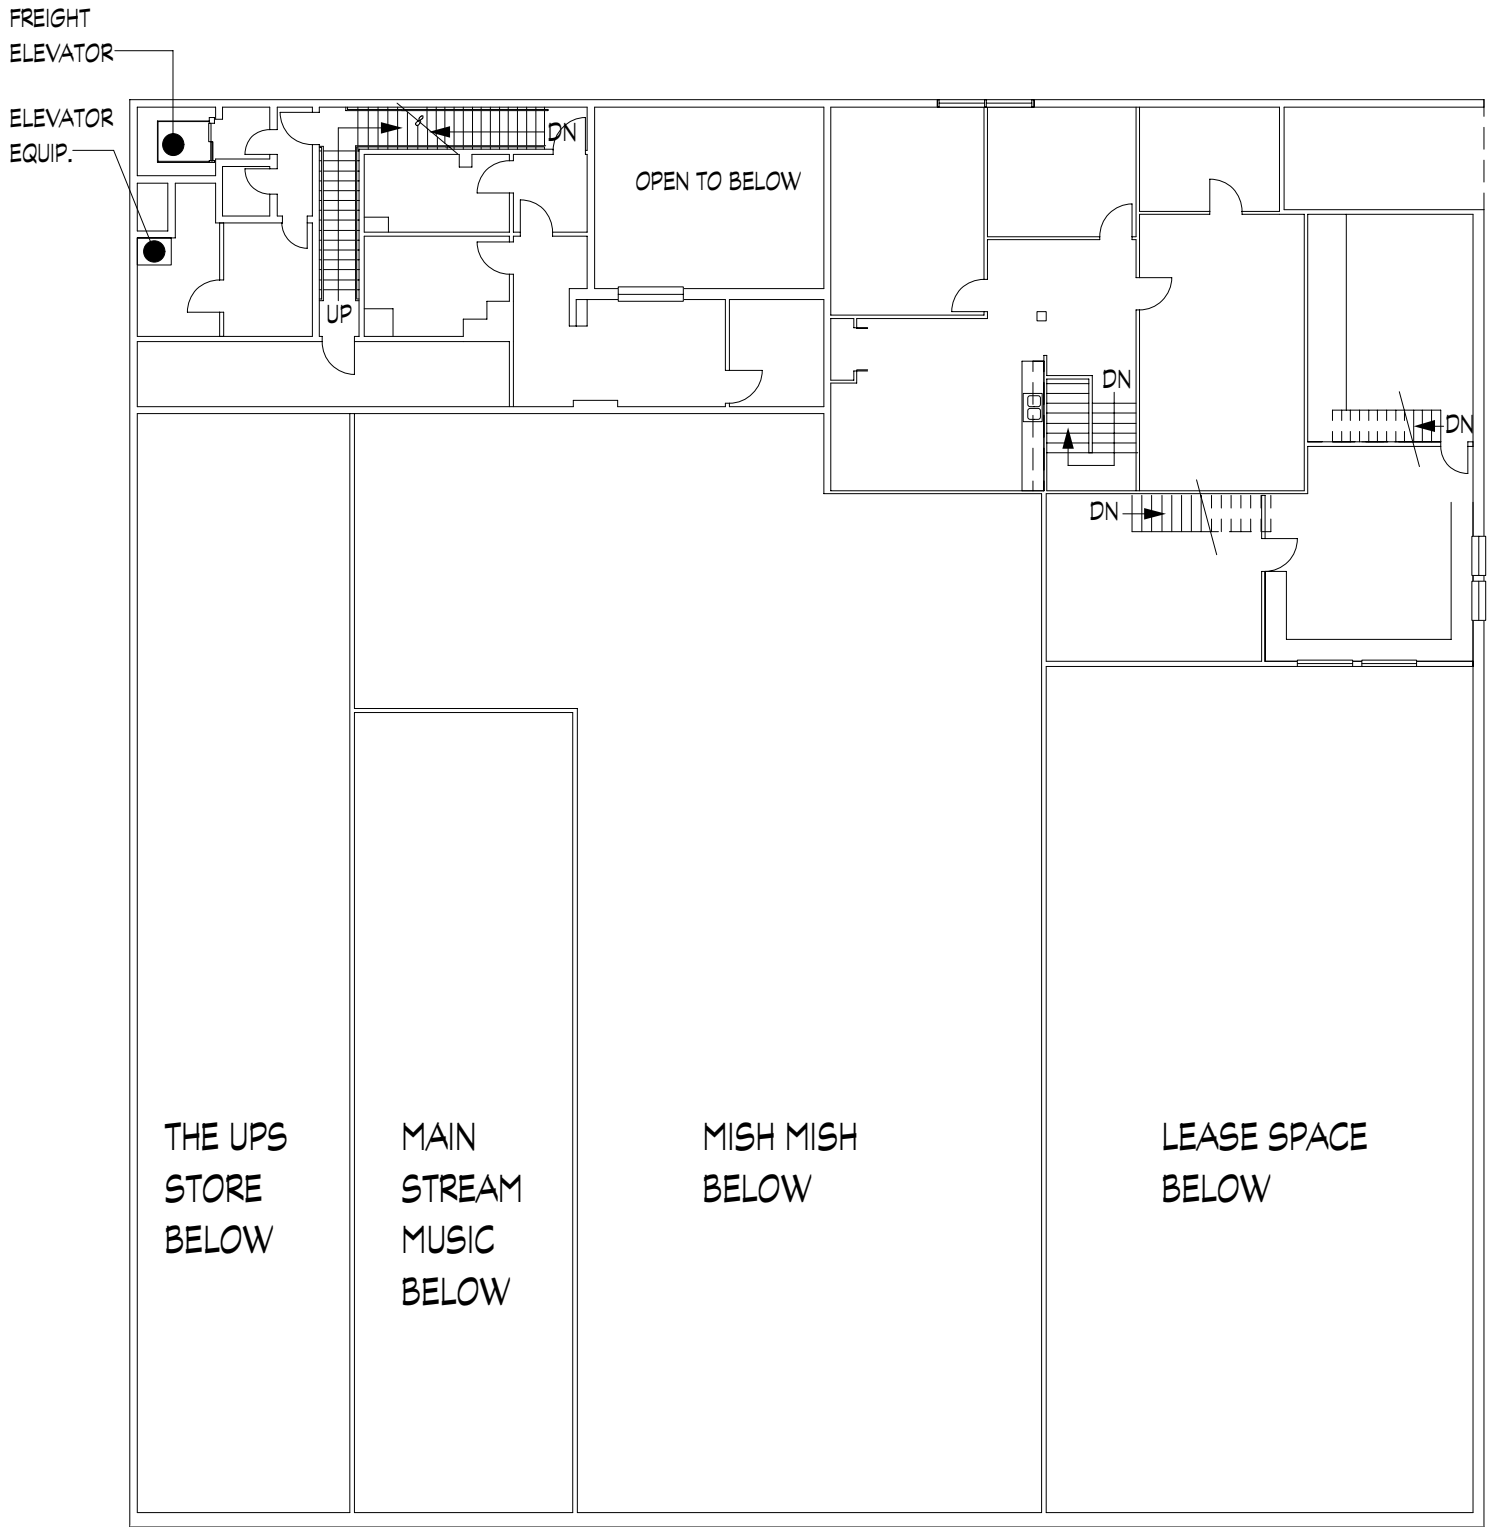

MEZZANINE FLOOR PLAN